
# EAST 16TH AVENUE 130.1 44 90°0'20" 43 - 12 51' - 12 51' 41 40 39 38 36 DOWNINGTON BLOCK 46 10 35 AM) 34 11 20' DENN 625.42' ( 12 33 32 14 31 90°0'36" 30 LEYDEN (70' ROW) SEE LOT DE 29 17 FOUND NO. 5 REBAR W/ ORANGE PLASTIC CAP, LS 9489 FOUND NO. 5 REBAR V ORANGE PLASTIC CAP, LS 948 25 45.93 46.00' 20.00' EAST COLFAX AVENUE **BLOCK DETAIL** SCALE: 1" = 50 25'

# EAST COLFAX LOFTS CONDOMINIUM MAP

LOCATED IN THE SOUTHWEST 1/4 OF SECTION 32, TOWNSHIP 3 SOUTH, RANGE 67 WEST OF THE 6TH P.M., CITY & COUNTY OF DENVER, STATE OF COLORADO SHEET 1 OF 2

LAND SURVEY PLAT

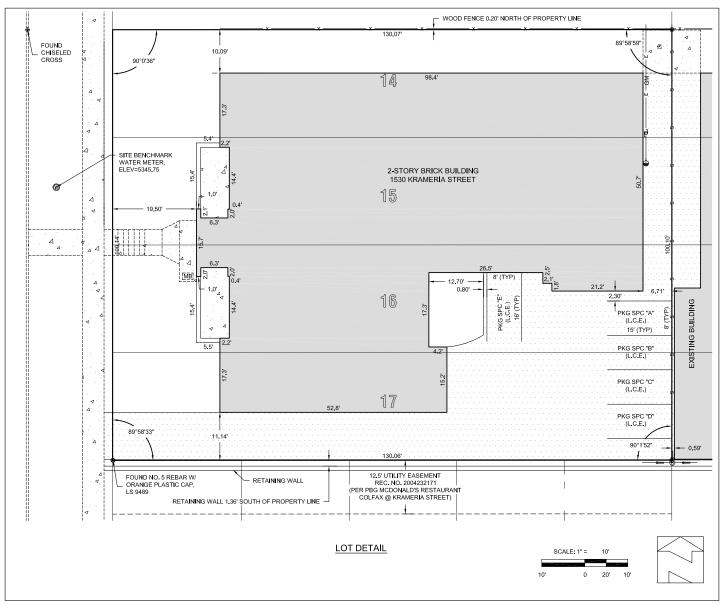

### **NOTES**

- ACCORDING TO COLORADO LAW, YOU MUST COMMENCE ANY LEGAL ACTION BASED UPON ANY DEFECT IN THIS SURVEY WITHIN THREE YEARS AFTER YOU FIRST DISCOVER SUCH DEFECT. IN NO EVENT, MAY ANY ACTION BASED UPON ANY DEFECT IN THIS SURVEY BE COMMENCED MORE THAN TEN YEARS FROM THE DATE OF CERTIFICATION SHOWN HEREON.
- THIS SURVEY DOES NOT CONSTITUTE A TITLE SEARCH BY GILLIANS LAND CONSULTANTS TO DETERMINE OWNERSHIP OF EASEMENTS OF RECORD, RIGHT OF WAY, AND TITLE OF RECORD. GILLIANS LAND CONSULTANTS RELIED UPON STEWART TITLE GUARANTY COMPANY ORDER NUMBER 90176735 VLO - 1ST REVISION, EFFECTIVE DATEMARCH 9, 2006 AT 7:45 A.M. FOR
- SCHEDULE B SECTION 2 EXCEPTIONS. THE FOLLOWING NOTES PERTAIN TO THE ITEM NUMBERS AS SHOWN ON THE B-2 EXCEPTIONS OF THE ABOVE NOTED TITLE COMMITMENT, ITEMS1-7 AND 9-10 ARE GENERAL EXCEPTIONS OR NON-SURVEY RELATED AND ARE NOT ADDRESSED. THESE ITEMS SHOULD BE REVIEWED BY LEGAL COLINSEL

ITEM 8 - TERMS, CONDITIONS, PROVISIONS, OBLIGATIONS AND EASEMENTS, CONTAINED IN CABLE TELEVISION INSTALLATION AGREEMENT, RECORDED SEPTEMBER 19, 1983, AT RECEPTION NUMBER 061516. BLANKET EASEMENT - NOT SHOW

- L.C.E. = LIMITED COMMON ELEMENT C.E. = COMMON ELEMENT
- AREAS DENOTED WITH A NUMBER ARE UNITS AREAS NOT DESIGNATED AS A UNIT ARE COMMON ELEMENTS.
- ALL TERMS USED IN THIS CONDOMINIUM MAP ARE EITHER DEFINED IN THIS MAP OR IN THE DECLARATION FOR EAST COLFAX FLATS.
- THE COMMON INTEREST COMMUNITY IS KNOWN AS "EAST COLFAX FLATS". THE COMMON INTEREST COMMUNITY IS CREATED BY THE DECLARATION AND THIS MAP AND INCLUDES ONLY THOSE UNITS AND COMMON ELEMENTS DESCRIBED THEREIN, AS THE SAME MAY BE SUPPLEMENTED ("DECLARATION").

### NOTES (CONTINUED)

- 8. EAST COLFAX FLATS IS GOVERNED BY A UNIT OWNERS ASSOCIATION, "\_
- ALL OF THE PROPERTY DESCRIBED ON THIS PLAT IS SUBJECT TO DEVELOPMENT RIGHTS AND SPECIAL DECLARANT
- 10. THE BOUNDARIES OF EACH UNIT ARE GRAPHICALLY DEPICTED UPON THIS MAP AND ARE DESCRIBED IN THE
- 11. ALL PORTIONS OF THE REAL ESTATE NOT LOCATED WITHIN UNITS SHALL BE COMMON ELEMENTS EXCEPT AS HAVE BEEN RESERVED BY THE DECLARANT IN THE DECLARATION.
- 12. THIS PLAT TOGETHER WITH THE DECLARATION AND THE UNITS SET FORTH IN THE DECLARATION AS BEING WITHIN THE COMMON INTEREST COMMUNITY (AS THE SAME MAY BE AMENDED) CREATES UNITS, COMMON ELEMENTS AND DEVELOPMENT RIGHTS.
- 13. THE UNITS AND COMMON ELEMENTS WHICH ARE SUBJECT TO THE DECLARATION, AND THUS PART OF THE COMMON INTEREST COMMUNITY ARE DESCRIBED IN THE DECLARATION, AS THE SAME MAY BE SUPPLEMENTED
- 14. THE CONCLUSIONS DENOTED ON THIS PLAT WERE OBTAINED USING THE FOLLOWING REFERENCES: DOWNINGTON SUBDIVISION RECORDED 1/3/1887 IN THE CITY & COUNTY OF DENVER CLERK AND RECORDERS OFFICE AT BOOK 4, PAGE 13, AND THE OFFICIAL SURVEY OFDOWNINGTON APPROVED 8/3/1897 UNDER ORDINANCE #46-1897.

RANGE LINE NOTES IN THE CITY ENGINEERS OFFICE AT THE CITY AND COUNTY BUILDING OF DENVER IN BOOK 208 AT PAGES 190-193 AND PAGES 144-147 AND BOOK 389 AT PAGES 146-147.

PROJECT BENCHMARKS: ELEVATIONS BASED ON CITY & COUNTY OF DENVER BENCHMARK 62B, CCD BRASS CAP AT THE SOUTHEAST CORNER OF LOCUST STREET AND COLFAX AVENUE ON THE TOP OF CURB AT THE INLET. ELEVATION = 5347.22 (NAVD 88).

SITE BENCHMARK: WATER METER ELEVATION = 5345.75 (NAVD 88).

### LAND DESCRIPTION (PER TITLE COMMITMENT)

LOTS 14 TO 17, INCLUSIVE, BLOCK 46 DOWNINGTON CITY AND COUNTY OF DENVER, STATE OF COLORADO

## LEGEND

- SET NO. 5 REBAR W/ GREEN PLASTIC CAP, LS 37601
- FOUND "+" CHISELED IN CONCRETE
- SANITARY SEWER MANHOLE (\$)
- WATER METER

Ф	POWER POLE	ABBREVIATIO
_		

		,
-0	GUY WIRE	
		F
5500.00	SPOT ELEVATION	F
		8
– x ––––	FENCE	N.
		F

ASPHALT SURFACE CALC'D

ONS RIGHT-OF-WAY ACRES SQUARE FEET MAII BOX AS MEASURED

PKG SPC PARKING SPACE OS OFFICIAL SURVE OFFICIAL SURVEY (SEE NOTE 14)

#### OWNER'S CERTIFICATE

GARY A. MOLINARO AND FRANK MOLINARO, AS OWNER OF THE HEREIN DESCRIBED REAL PROPERTY, DOES HEREBY CERTIFY THAT THIS
CONDOMINIUM MAP HAS BEEN PREPARED PURSUANT TO THE PURPOSES
STATED IN THE DECLARATION FOR \_\_\_\_\_\_\_ IN THE RECO

OF THE CLE COUNTY.	RK AND RECORDERS OFFICE OF			
AS RECORDEDUNDER RECEPTION NO.				
BY:	<del></del>			
NAME:	GARY A. MOLINARO			
TITLE:	<del></del>			
NOTORIAL	<u> </u>			
STATE OF	}			
COUNTY OF	} ss }			
THE FOREGOING INSTRUMENT WAS ACKNOWLEDGED BEFORE ME THIS DAY OF 2006, BY AS				
WITNESS MY	Y HAND AND OFFICIAL SEAL			
MY COMMISSION EXPIRES:				
	NOTARY PUBLIC			
BY:				
NAME:	FRANK MOLINARO			
TITLE:				
NOTORIAL				
STATE OF	}			
COUNTY OF	} ss }			
	OING INSTRUMENT WAS ACKNOWLEDGED BEFORE ME THIS , 2006, BYAS			

#### LENDER'S CERTIFICATE

MY COMMISSION EXPIRES:

WITNESS MY HAND AND OFFICIAL SEAL

, WHICH HOLDS A DEED OF TRUST ON THE PROPERTY SUBJECT TO THE MAP HEREON, AND HEREBY CONSENTS AND APPROVES OF THE RECORDING OF THE MAP AND THE SUBMISSION OF THE PROPERTY TO THE TERMS AND CONDITIONS OF THE DECLARATION OF

NOTARY PUBLIC

CONDOMINIUMS	FOR THE EAST COLFAX FLATS.
BY:	
NOTARIAL	
STATE OF	}
COUNTY OF	} ss }
	INSTRUMENT WAS ACKNOWLEDGED BEFORE ME THIS AS
	<del></del>
WITNESS MY HAN	ID AND OFFICIAL SEAL
MY COMMISSION	EXPIRES:

## SURVEYOR'S CERTIFICATE

I, ROBERT E. HARRIS, PROFESSIONAL LAND SURVEYOR IN THE STATE OF COLORADO, ON THE BASIS OF MY KNOWLEDGE, INFORMATION AND BELIEF, DO HEREBY CERTIFY THAT THIS CONDOMINIUM PLAT SUBSTANTIALLY DEPICTS THE LOCATION AND THE HORIZONTAL AND VERTICAL MEASUREMENTS OF ALL FLOORS AND LEVELS, UNITS, UNIT DESIGNATIONS, AND THE DIMENSIONS OF ALL UNITS, INFORMATION REQUIRED UNDER C.R.S. SEC 38-33.3-209 AND

NOTARY PUBLIC



#### CLERK & RECORDER

I HEREBY CERTIFY THAT THIS INSTRUMENT WAS FILED FOR RECOI OFFICE AT O'CLOCK M. ON THE DAY OF 20 AND DULY RECORDED AT RECEPTION N	
BOOKPAGE	
FEES PAID RECORDER DEPUTY	



COLORADO

COLFAX FLATS

COUNTY OF DENVER, EAST જ CITY


600


JOB NO: 0606 CHECKED: REH DESIGNER: SSUE DATE: 6-12-06

SCALE: AS NOTED

# **EAST COLFAX FLATS**

LOCATED IN THE SOUTHWEST 1/4 OF SECTION 32, TOWNSHIP 3 SOUTH, RANGE 67 WEST OF THE 6TH P.M., CITY & COUNTY OF DENVER, STATE OF COLORADO SHEET 2 OF 2 PLAN AND ELEVATION VIEWS

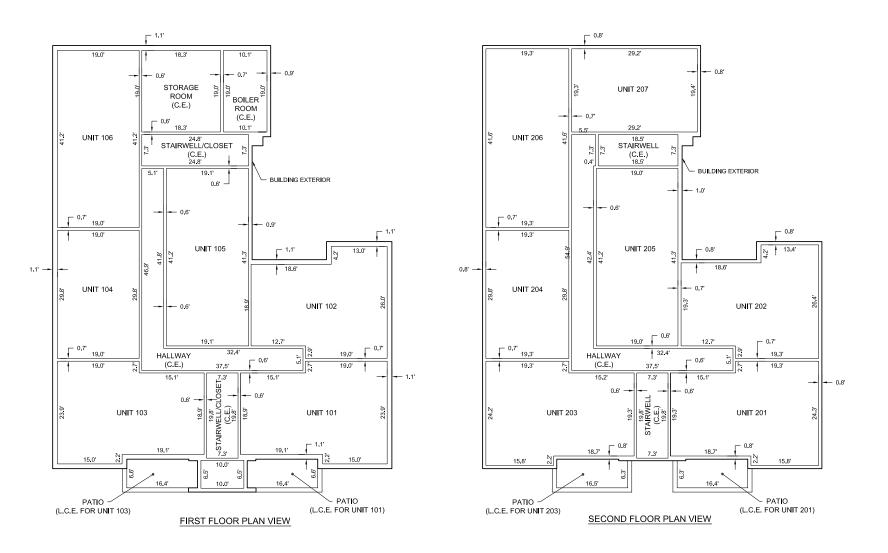


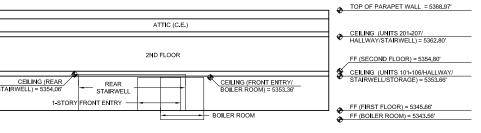

ELEVATION VIEW LOOKING EAST

## <u>NOTES</u>

1. SEE SHEET 1 FOR EXTERIOR BUILDING DIMENSIONS.

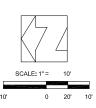

CONDOMINIUM MAP
COUNTY OF DENVER, COLORADO EAST COLFAX FLATS

∞



Gilliams

JOB NO: 06060
DRAWN: ALB
CHECKED: REH
DESIGNER:
ISSUE DATE: 6-12-06

SCALE: 1"=10" FILE: 06060 CONDO.E

2